



BUILDING CODE COMPLIANCE OFFICE
METRO-DADE FLAGLER BUILDING
140 WEST FLAGLER STREET, SUITE 1603
MIAMI, FLORIDA 33130-1563
(305) 375-2901 FAX (305) 375-2908

CONTRACTOR LICENSING SECTION
(305) 375-2527 FAX (305) 375-2558

CONTRACTOR ENFORCEMENT DIVISION
(305) 375-2966 FAX (305) 375-2908

PRODUCT CONTROL DIVISION
(305) 375-2902 FAX (305) 372-6339

PRODUCT CONTROL NOTICE OF ACCEPTANCE

Andersen Corporation
100 Fourth Avenue North
Bayport ,MN 55003-1096

Your application for Notice of Acceptance (NOA) of:

"Perma-Shield" Vinyl Clad Wood Awning Windows

under Chapter 8 of the Code of Miami-Dade County governing the use of Alternate Materials and Types of Construction, and completely described herein, has been recommended for acceptance by the Miami-Dade County Building Code Compliance Office (BCCO) under the conditions specified herein.

This NOA shall not be valid after the expiration date stated below. BCCO reserves the right to secure this product or material at any time from a jobsite or manufacturer's plant for quality control testing. If this product or material fails to perform in the approved manner, BCCO may revoke, modify, or suspend the use of such product or material immediately. BCCO reserves the right to revoke this approval, if it is determined by BCCO that this product or material fails to meet the requirements of the South Florida Building Code.

The expense of such testing will be incurred by the manufacturer.

ACCEPTANCE NO.: 00-0801.01
EXPIRES: 08/16/2004

Raul Rodriguez
Chief Product Control Division

THIS IS THE COVERSHEET, SEE ADDITIONAL PAGES FOR SPECIFIC AND GENERAL
CONDITIONS
BUILDING CODE & PRODUCT REVIEW COMMITTEE

This application for Product Approval has been reviewed by the BCCO and approved by the Building Code and Product Review Committee to be used in Miami-Dade County, Florida under the conditions set forth above.

Francisco J. Quintana, R.A.
Director
Miami-Dade County
Building Code Compliance Office

APPROVED: 08/16/2001

Andersen Corporation

ACCEPTANCE No.: 00-0801.01

APPROVED : August 16, 2001

EXPIRES : August 16, 2004

NOTICE OF ACCEPTANCE: SPECIFIC CONDITIONS

1. SCOPE

- 1.1 This approves a wood awning window, as described in Section 2 of this Notice of Acceptance, designed to comply with the South Florida Building Code (SFBC), 1994 Edition for Miami-Dade County, for the locations where the pressure requirements, as determined by SFBC Chapter 23, do not exceed the Design Pressure Rating values indicated in the approved drawings.

2. PRODUCT DESCRIPTION

- 2.1 The "**Perma-shield**" Vinyl clad Wood Awning Window and its components shall be constructed in strict compliance with the following documents: Drawing No **Dade-40135**, titled "Awning Windows" Sheets 1 thru 6 of 6, dated 07/14/00, last revised on 07-11-01, prepared by manufacturer, bearing the Miami-Dade County Product Control approval stamp with the Notice of Acceptance number and approval date by the Miami-Dade County Product Control Division. These documents shall hereinafter be referred to as the approved drawings.

3. LIMITATIONS

- 3.1 This approval applies to single unit applications, as shown approved drawings.

4. INSTALLATION

- 4.1 The vinyl clad wood awning window and its components shall be installed in strict compliance with the approved drawings.
- 4.2 Hurricane protection system (shutters): the installation of this unit **will require** a hurricane protection system.

5. LABELING

- 5.1 Each unit shall bear a permanent label with the manufacturer's name or logo, city, state and following statement: "Miami-Dade County Product Control Approved".

6. BUILDING PERMIT REQUIREMENTS

- 6.1 Application for building permit shall be accompanied by copies of the following:
- 6.1.1 This Notice of Acceptance
- 6.1.2 Duplicate copies of the approved drawings, as identified in Section 2 of this Notice of Acceptance, clearly marked to show the components selected for the proposed installation.
- 6.1.3 Any other documents required by the Building Official or the South Florida Building Code (SFBC) in order to properly evaluate the installation of this system.

Ishaq I. Chanda
Ishaq I. Chanda, P.E. Product Control Examiner
Product Control Division

Andersen Corporation

ACCEPTANCE No.: 00-0801.01

APPROVED : August 16, 2001

EXPIRES : August 16, 2004

NOTICE OF ACCEPTANCE: STANDARD CONDITIONS

1. A. Renewal of this Acceptance (approval) shall be considered after a renewal application has been filed and the original submitted documentation, including test supporting data, engineering documents, are no older than eight (8) years.
2. Any and all approved products shall be permanently labeled with the manufacturer's name, city, state, and the following statement: "Miami-Dade County Product Control Approved", or as specifically stated in the specific conditions of this Acceptance.
3. Renewals of Acceptance will not be considered if:
 - a) There has been a change in the South Florida Building Code affecting the evaluation of this product and the product is not in compliance with the code changes;
 - b) The product is no longer the same product (identical) as the one originally approved;
 - c) If the Acceptance holder has not complied with all the requirements of this acceptance, including the correct installation of the product;
 - d) The engineer who originally prepared, signed and sealed the required documentation initially submitted is no longer practicing the engineering profession.
4. Any revision or change in the materials, use, and/or manufacture of the product or process shall automatically be cause for termination of this Acceptance, unless prior written approval has been requested (through the filing of a revision application with appropriate fee) and granted by this office.
5. Any of the following shall also be grounds for removal of this Acceptance:
 - a) Unsatisfactory performance of this product or process.
 - b) Misuse of this Acceptance as an endorsement of any product, for sales, advertising or any other purpose.
6. The Notice of Acceptance number preceded by the words Miami-Dade County, Florida, and followed by the expiration date may be displayed in advertising literature. If any portion of the Notice of Acceptance is displayed, then it shall be done in its entirety.
7. A copy of this Acceptance as well as approved drawings and other documents, where it applies, shall be provided to the user by the manufacturer or its distributors and shall be available for inspection at the job site at all time. The engineer need not reseal the copies.
8. Failure to comply with any section of this Acceptance shall be cause for termination and removal of Acceptance.
9. This Notice of Acceptance consists of pages 1, 2 and this last page 3.

END OF THIS ACCEPTANCE

Ishaq I. Chanda
Ishaq I. Chanda, P.E. Product Control Examiner
Product Control Division

Andersen Corporation

ACCEPTANCE No.: 00-0801.01

APPROVED : August 16, 2001

EXPIRES : August 16, 2004

NOTICE OF ACCEPTANCE: EVIDENCE SUBMITTED
(For File ONLY. Not part of NOA.)

A. DRAWINGS

1. Manufacturer's parts and sections drawings.
2. Drawing No **Dade-40135**, titled "Awning Windows" Sheets 1 thru 6 of 6, dated 07/14/00, last revised on 07-11-01, prepared by manufacturer

B. TESTS

1. Test reports on
 - 1) Air Infiltration Test, per PA 202-94
 - 2) Uniform Static Air Pressure Test, Loading per PA 202-94
 - 3) Water Resistance Test, per PA 202-94
 - 4) Forced Entry Resistance Test, per AAMA 1303.5 and PA 202-94.along with manufacturer's parts and section drawings marked-up by Architectural Testing Inc. Test Report No. **ATI-02-32059.01** dated 02/25/00 revised by addendum letter dated 3-21-01, signed and sealed by Alan N. Reeves, P.E.

C. CALCULATIONS (see file#98-0624.05)

1. Window performance analysis & anchor verification calculations for vinyl clad wood awning window, dated 07-17-00, prepared by and signed and sealed by Richard Boyette, P.E.

D. MATERIAL CERTIFICATIONS

1. Test report for "Surface Burning Characteristics for Building Products" for PVC plastic materials per ASTM E84, report No. #J98002651-004 dated April 06, 1988, issued to Andersen Corporation by Intertek Testing Services(ITS).
2. Test report for "Rate of Burning" per ASTM-635-81 issued by Spring Testing Institute dated January 18, 1984 to Andersen Corp for PVC material.
3. Test report for "Self ignition temperature" for plastic materials per ASTM D-1929, report No. #J98002653-004 dated April. 27, 1988, issued by Intertek Testing Services(ITS) to Andersen Corp for PVC material.


E. STATEMENTS

1. Statement letter of conformance, dated July 18, 2000, and statement "no financial interest" dated 12-11-00, signed & sealed by Richard Boyette, P.E.
2. Laboratory compliance letter, issued by Architectural Testing Inc., dated 14th April 2000, signed and sealed by Allen N. Reeves, P.E.
3. Addendum letter to test report dated 03-21-01 issued by Architectural Testing Inc, signed and sealed by Allen N. Reeves, P. E.

D. OTHER

1. Weathering for Vinyl Clad wood jambs not applicable due to clad being non-structural in this case.
2. Test Plan proposal, dated January 10, 2000, approved by this office

Ishaq I. Chanda
Ishaq I. Chanda, P.E. Product Control Examiner
Product Control Division

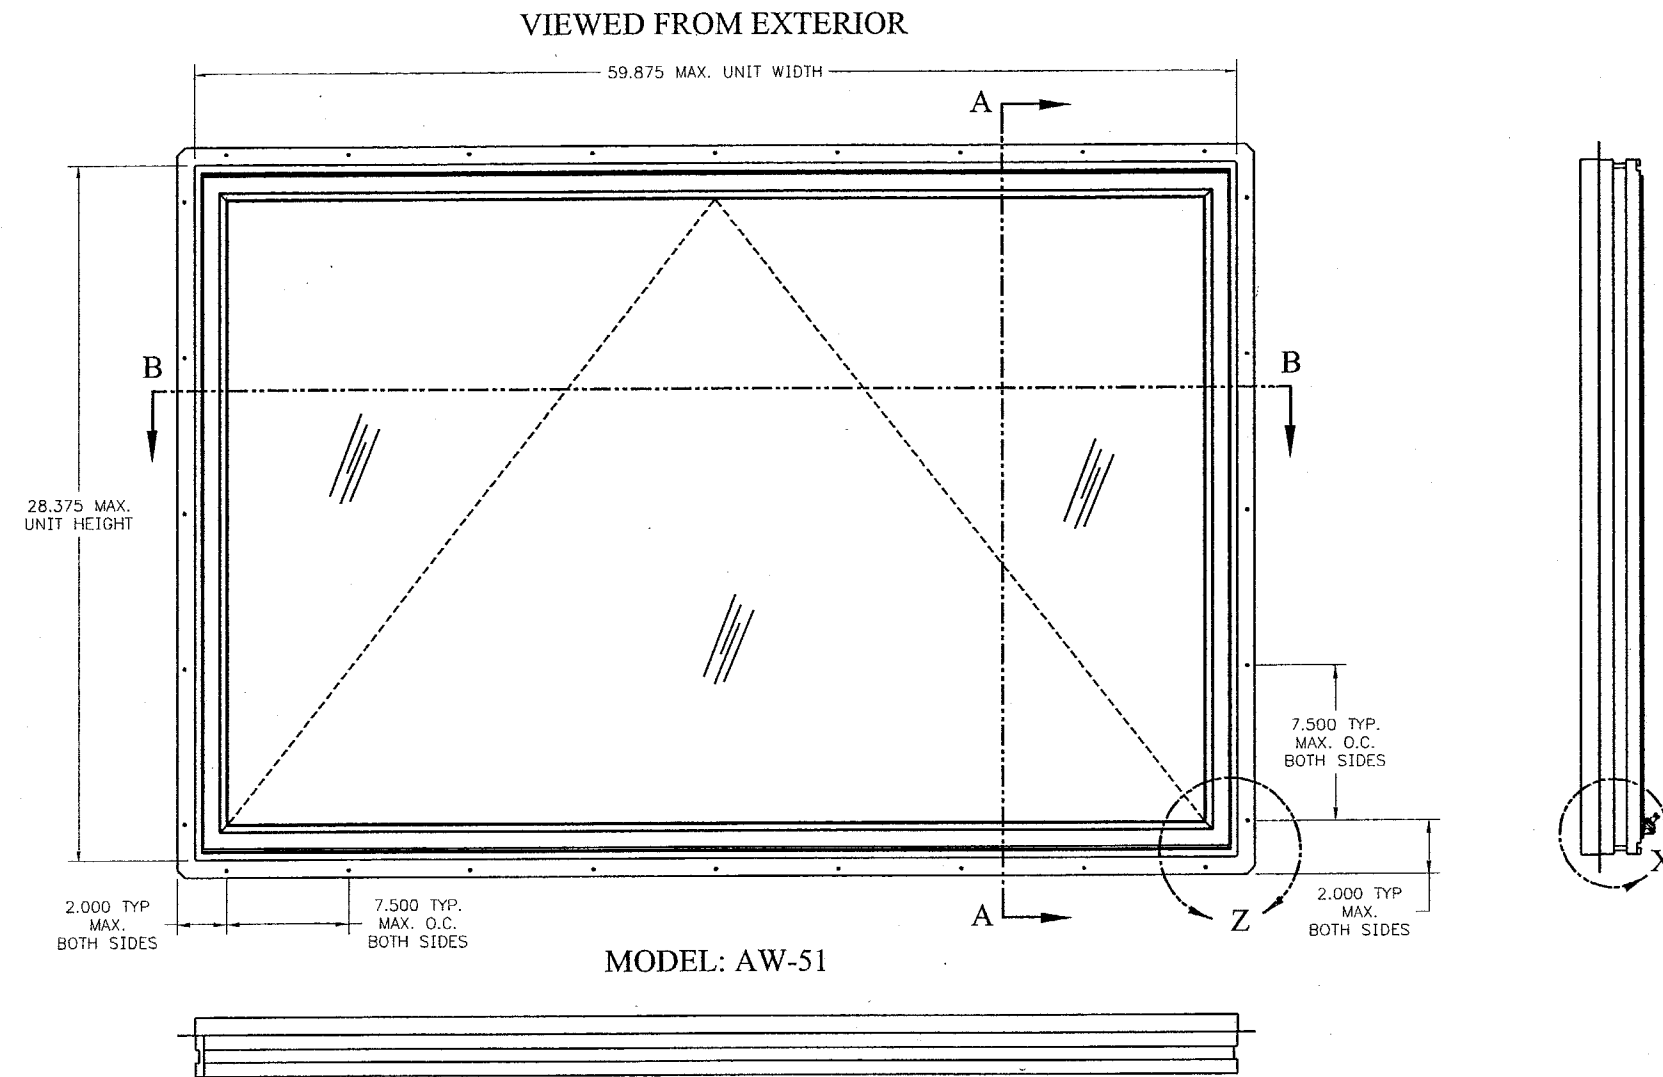

APPROVED AS COMPLYING WITH THE
SOUTH FLORIDA BUILDING CODE
DATE AUGUST 16, 2001
BY Isaac I. Chanda
PRODUCT CONTROL DIVISION
BUILDING CODE COMPLIANCE OFFICE
ACCEPTANCE NO. 00-0801.01

NOTES:

- INSTALLATION METHOD:**
THE SPECIMEN WAS INSTALLED INTO A GRADE 2 SPF 2" BY 6" WOOD BUCK. THE NAILING FLANGE WAS SECURED USING 1-3/4" ROOFING NAILS SPACED 2" FROM ENDS AND 7-1/2" ON CENTER. THE FLANGE WAS SEALED TO THE BUCK WITH SILICONE.
- GLAZING SPECIFICATIONS:**
THE UNITS UTILIZED NOMINAL 5/8" (.625 STANDARD) THICK INSULATING GLASS FABRICATED FROM ONE NOMINAL 1/8" (.117 STANDARD) HIGH-PERFORMANCE (ANNEALED) OUTSIDE LITE AND ONE NOMINAL 1/8" (.122 STANDARD) HEAT-STRENGTHENED INSIDE LITE SEPARATED BY A DESICCANT FILLED METAL SPACER.
- GLAZING METHOD:**
GLASS WAS SET FROM THE EXTERIOR AGAINST A GE-2512 SILICONE BACKBEDDING. A DUAL-DUROMETER VINYL GLAZING BEAD WAS USED AT THE EXTERIOR.
- FRAME CONSTRUCTION:**
FRAME MEMBERS WERE COPED AND SECURED WITH THREE STAPLES PER CORNER. SECURED WITH THREE STAPLES TO THE TOP AND BOTTOM MEMBERS. VINYL CLADDING WAS BONDED TO THE EXTERIOR FRAME MEMBERS.
- SASH CONSTRUCTION:**
THE SASH WAS COMPRISED OF VINYL-WRAPPED WOOD WITH THE VINYL CORNERS MITER-CUT AND WELDED.
- GLASS BITE = 0.436".
- MIAMI-DADE COUNTY APPROVED SHUTTERS REQUIRED FOR INSTALLATION.

TITLE	
AWNING WINDOWS STANDARD PRODUCT	
Andersen Corporation Bayport, Minnesota 55003	
THESE DRAWINGS ARE PROVIDED AS A SERVICE BY ANDERSEN CORPORATION FOR THE BENEFIT OF ITS CUSTOMERS. FINAL RESPONSIBILITY FOR ACCURACY OF DESIGN, FINAL SPECIFICATIONS, DRAWINGS AND FOR THE ACTUAL INSTALLATION SUGGESTED BY THESE DRAWINGS LIES WITH THE ARCHITECT, ENGINEER AND/OR CONTRACTOR.	
COPYRIGHT ANDERSEN CORPORATION 1998. ALL RIGHTS RESERVED.	
APPROVE/DATE	DRAWING NUMBER
7/11/01	DADE-40135
SHT. 1 OF 6	

C	7/11/01
B	1/7/01
A	7/14/00
REVISION	

32	JAMB, SIDE	29095	PONDEROSA PINE	1.395	4.125
31	JAMB, HEAD/SILL	29094	PONDEROSA PINE	1.109	4.125
30	SCREW, #8 X 1-3/16"	3251205	STEEL	1.188	Ø0.164
29	SCREW, #7 X 5/8" (SPECIAL)	3620215	STEEL	0.625	Ø0.164
28	SCREW, #7 X 5/8" (FLAT)	3620730	STEEL	0.625	Ø0.164
27	SCREW, #8 X 1"	3621530	STEEL	1.031	Ø0.179
26	LOCK, ASSMBLY LH/RH	30813/30814	STEEL	-	-
25	SCREW, #8 X 5/8"	3622315	STEEL	0.625	Ø0.164
24	KEEPER, AWNING	40149	STEEL/NYLON	2.435	0.875
23	GLAZING BEAD - .625	29154	PVC	0.705	0.998
22	STAPLE, 1/2" X 2" X 16 GA.	4220206	STEEL	2.000	0.500
21	SILICONE	ANY SILICONE CAN BE USED FOR THIS APPLICATION			
20	WEATHERSTRIP BULB, RAIL	30213	PVC	0.490	0.270
19	WEATHERSTRIP BULB, STILE	30214	PVC	0.490	0.270
18	SPACER, GLASS (SETTING BLOCK)	20065	PVC	0.900	2.000
17	SEALANT (DOW CORNING 983-2)	MDS0012	SILICONE	-	-
16	WATERBAR	40008	PVC	0.656	0.438
15	GLASS, HIGH PERFORMANCE SUN II	00080	-	-	-
	GLASS, HIGH PERFORMANCE	00052	-	-	-
	GLASS, CLEAR	00009	-	-	-
14	NAIL, 1-1/2 LG. BRAD	4235252	GALVANIZED STEEL	1.500	Ø0.059
13	OPERATOR, (A21 SIZE)	40018	STEEL	2.481	17.687
	OPERATOR	40140/40017	STEEL	2.481	11.812
12	SCREW, #7 X 5/8"	3620780	GALVANIZED STEEL	0.625	Ø0.164
11	ROD, FORMED	40117	CRS	0.409	9.811 MIN.
10	HINGE, 7227, 7207 LH	40012	STAINLESS STEEL	6.631	6.876
9	HINGE, 7227, 7207 RH	40011	STAINLESS STEEL	-	-
8	HINGE, 7168 LH	30441	STAINLESS STEEL	-	-
7	HINGE, 7168 RH	30440	STEEL	-	-
6	NAIL, 1-3/4" ROOFING	-	GALVANIZED STEEL	1.750	Ø0.140
5	STOP, RH	29100	PONDEROSA PINE	0.906	2.000
	STOP, LH	29098	PONDEROSA PINE	1.158	2.000
4	STOP, HEAD	29100	PONDEROSA PINE	1.158	2.000
3	STOP, SILL	29102	PONDEROSA PINE	1.158	2.000
2	SASH	30016/30017	VINYL/PINE	1.554	2.000
1	COVER, FRAME	30023	PVC	-	-
ITEM NO.	DESCRIPTION	PART	MATERIAL	HEIGHT	WIDTH

PART REFERENCE LIST

ALL PARTS MANUFACTURED TO ANDERSEN SPECIFICATION
AS NOTED BY ABOVE PART NUMBERS

17	BEAD	SEALANT (DOW-CORNING 983-2)	ATTACHMENT OF GLASS TO SASH
12	2	SCREW, #7 X 5/8"	ATTACHMENT OF FORMED ROD TO SASH
25	4	SCREW, #8 X 5/8"	ATTACHMENT OF KEEPER TO SASH
ITEM	QTY	DESCRIPTION	LOCATION

SASH FASTNERS LIST

29	2	SCREW, #7 X 5/8" (SPECIAL)	ATTACHMENT OF HINGE TO FRAME
28	8	SCREW, #7 X 5/8" (FLAT)	ATTACHMENT OF HINGE TO FRAME
27	4	SCREW, #8 X 1"	ATTACHMENT OF LOCK ASSEMBLY TO FRAME
30	3	SCREW, #8 X 1-3/16"	ATTACHMENT OF OPERATOR TO FRAME
-	BEAD	ADHESIVE	ATTACHMENT OF COVER FRAME (INSIDE) TO FRAME
22	8	STAPLE, 1/2" X 2" X 16 GA.	ATTACHMENT OF RAIL CORNERS TO STILE CORNERS
ITEM	QTY	DESCRIPTION	LOCATION

FRAME FASTNERS LIST





AW51	+50/-50	28.375	59.875	27.219	58.312	24.844	24.000	55.938	55.062	30.031	26.173
AW451	+50/-50	28.375	52.812	27.219	51.250	24.844	24.000	48.875	48.000	26.500	22.641
AW41	+50/-50	28.375	48.000	27.219	46.438	24.844	24.000	44.062	43.188	24.093	20.235
AW351	+50/-50	28.375	40.812	27.219	39.250	24.844	24.000	36.875	36.000	20.500	16.641
AW31	+50/-50	28.375	35.938	27.219	34.375	24.844	24.000	32.000	31.125	18.062	14.204
AW251	+50/-50	28.375	28.375	27.219	26.812	24.844	24.000	24.438	23.562	14.281	10.423
AW21	+50/-50	28.375	24.125	27.219	22.562	24.844	24.000	20.188	19.312	11.281	7.423
A51	+50/-50	24.125	59.875	22.969	58.312	20.594	19.750	55.938	55.062	30.031	26.173
A451	+50/-50	24.125	52.812	22.969	51.250	20.594	19.750	48.875	48.000	26.500	22.641
A41	+70/-70	24.125	48.000	22.969	46.438	20.594	19.750	44.062	43.188	24.093	20.235
A351	+70/-70	24.125	40.812	22.969	39.250	20.594	19.750	36.875	36.000	20.500	16.641
A31	+70/-70	24.125	35.938	22.969	34.375	20.594	19.750	32.000	31.125	18.062	14.204
A251	+70/-70	24.125	28.375	22.969	26.812	20.594	19.750	24.438	23.562	14.281	10.423
A21	+70/-70	24.125	24.125	22.969	22.562	20.594	19.750	20.188	19.312	11.281	7.423
AN51	+50/-50	20.500	59.875	19.344	58.312	16.969	16.125	55.938	55.062	30.031	26.173
AN451	+50/-50	20.500	52.812	19.344	51.250	16.969	16.125	48.875	48.000	26.500	22.641
AN41	+70/-70	20.500	48.000	19.344	46.438	16.969	16.125	44.062	43.188	24.093	20.235
AN351	+70/-70	20.500	40.812	19.344	39.250	16.969	16.125	36.875	36.000	20.500	16.641
AN31	+70/-70	20.500	35.938	19.344	34.375	16.969	16.125	32.000	31.125	18.062	14.204
AN251	+70/-70	20.500	28.375	19.344	26.812	16.969	16.125	24.438	23.562	14.281	10.423
AN21	+70/-70	20.500	24.125	19.344	22.562	16.969	16.125	20.188	19.312	11.281	7.423
AR51	+50/-50	17.000	59.875	15.844	58.312	13.469	12.625	55.938	55.062	30.031	26.173
AR451	+50/-50	17.000	52.812	15.844	51.250	13.469	12.625	48.875	48.000	26.500	22.641
AR41	+70/-70	17.000	48.000	15.844	46.438	13.469	12.625	44.062	43.188	24.093	20.235
AR351	+70/-70	17.000	40.812	15.844	39.250	13.469	12.625	36.875	36.000	20.500	16.641
AR31	+70/-70	17.000	35.938	15.844	34.375	13.469	12.625	32.000	31.125	18.062	14.204
AR251	+70/-70	17.000	28.375	15.844	26.812	13.469	12.625	24.438	23.562	14.281	10.423
AR21	+70/-70	17.000	24.125	15.844	22.562	13.469	12.625	20.188	19.312	11.281	7.423
SIZE DES.	DP-RATINGS (PSF)	HEIGHT	WIDTH	HEIGHT	WIDTH	GLASS DIMENSION	DAYLIGHT OPENING	GLASS DIMENSION	DAYLIGHT OPENING	DIM."A"	DIM."B"
		UNIT DIMENSIONS		SASH DIMENSIONS		GLASS DIMENSION HEIGHT		GLASS DIMENSION WIDTH			

* INDICATES TESTED UNITS

APPROVED AS COMPLYING WITH THE
SOUTH FLORIDA BUILDING CODE
DATE AUGUST 16, 2001
BY Shay L. Chaudh
PRODUCT CONTROL DIVISION
BUILDING CODE COMPLIANCE OFFICE
ACCEPTANCE NO. 00-0801-01

TITLE	
AWNING WINDOWS STANDARD PRODUCT	
Andersen Corporation Bayport, Minnesota 55003	
THESE DRAWINGS ARE PROVIDED AS A SERVICE BY ANDERSEN CORPORATION FOR THE BENEFIT OF ITS CUSTOMERS. FINAL RESPONSIBILITY FOR ACCURACY OF DESIGN, FINAL SPECIFICATIONS, DRAWINGS AND FOR THE ACTUAL INSTALLATION SUGGESTED BY THESE DRAWINGS LIES WITH THE ARCHITECT, ENGINEER AND/OR CONTRACTOR.	
COPYRIGHT ANDERSEN CORPORATION 1998. ALL RIGHTS RESERVED.	
APPROVE/DATE	DRAWING NUMBER
7/11/01	DADE-40135
SHT. 2 OF 6	


C	7/11/01
B	1/7/01
A	7/14/00
REVISION	

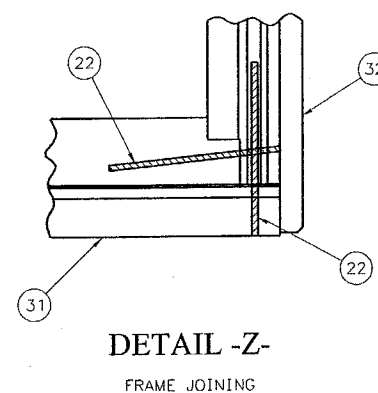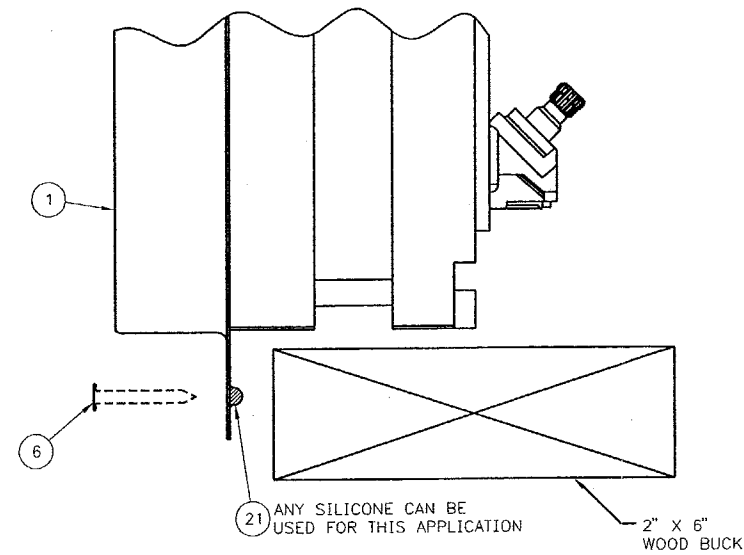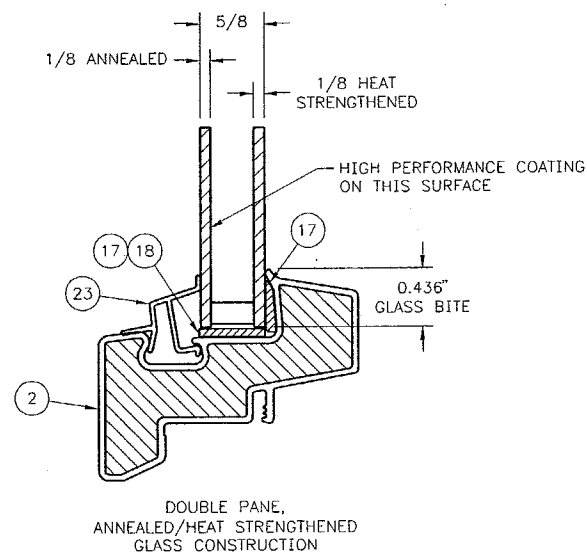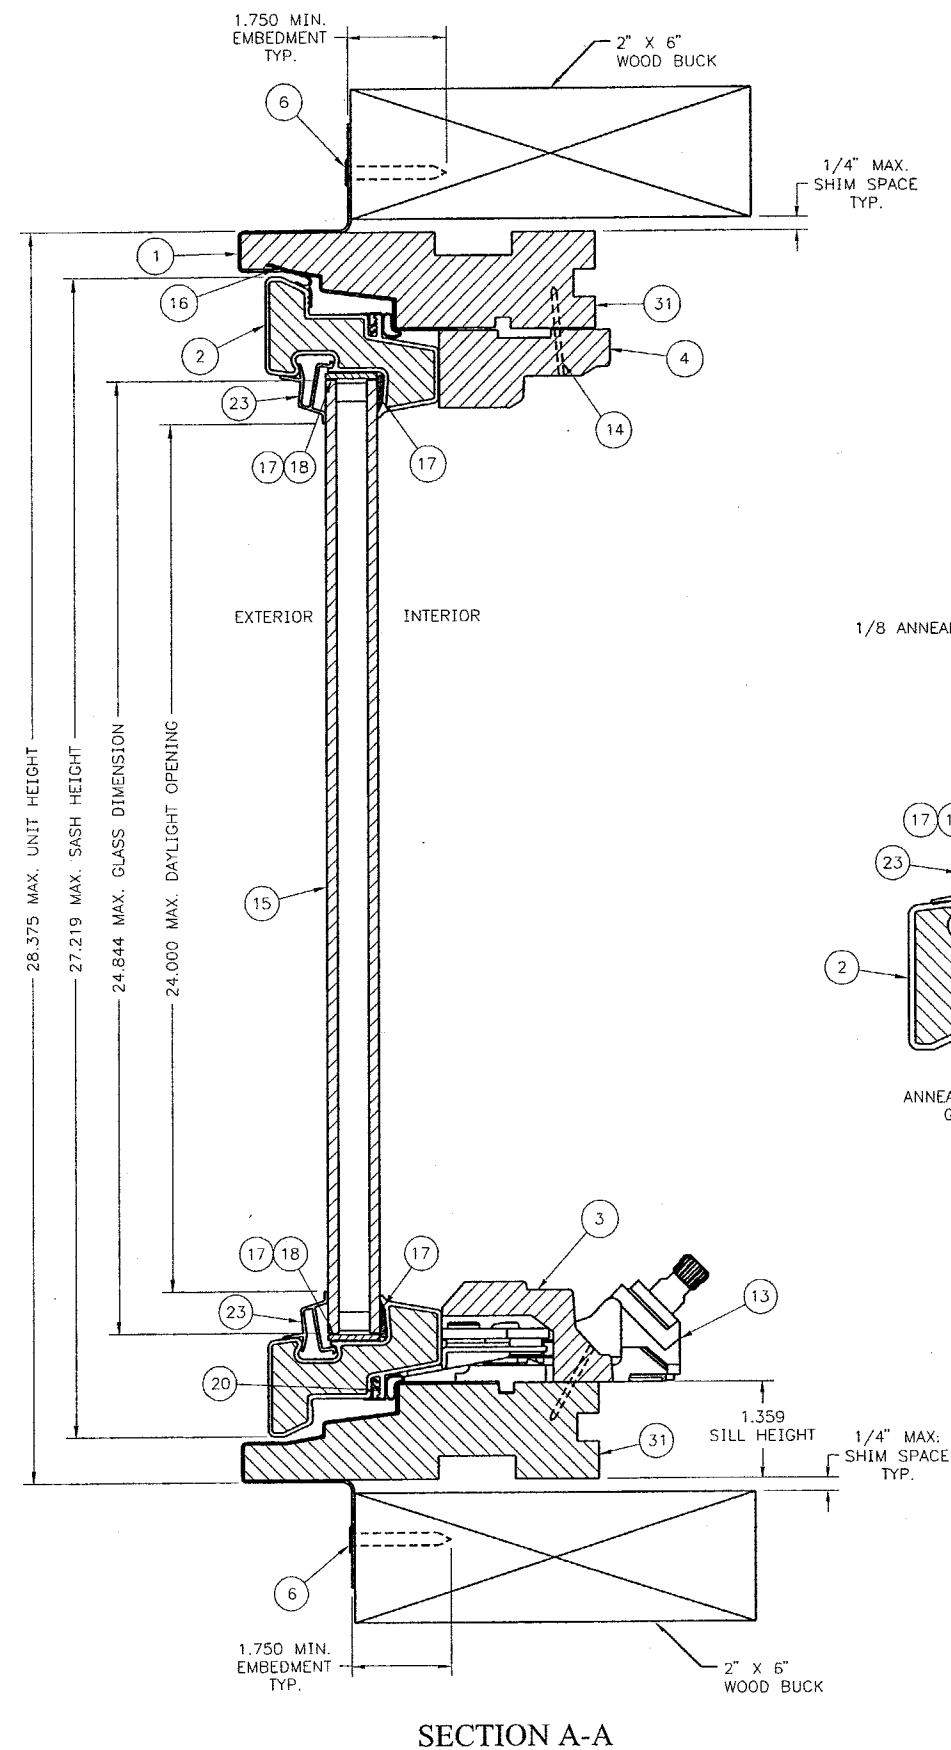

APPROVED AS COMPLYING WITH THE
SOUTH FLORIDA BUILDING CODE
DATE AUGUST 16, 2001
BY Isaac J. Zauda
PRODUCT CONTROL DIVISION
BUILDING CODE COMPLIANCE OFFICE
ACCEPTANCE NO. 00-0801-01

TITLE	
AWNING WINDOWS STANDARD PRODUCT	
Andersen Corporation Bayport, Minnesota 55003	
THESE DRAWINGS ARE PROVIDED AS A SERVICE BY ANDERSEN CORPORATION FOR THE BENEFIT OF ITS CUSTOMERS. FINAL RESPONSIBILITY FOR ACCURACY OF DESIGN, FINAL SPECIFICATIONS, DRAWINGS AND FOR THE ACTUAL INSTALLATION SUGGESTED BY THESE DRAWINGS LIES WITH THE ARCHITECT, ENGINEER AND/OR CONTRACTOR.	
COPYRIGHT ANDERSEN CORPORATION 1998. ALL RIGHTS RESERVED.	
APPROVE/DATE	DRAWING NUMBER
7/11/01	DADE-40135
SHT. 3 OF 6	

C	7/11/01
B	1/7/01
A	7/14/00
REVISION	


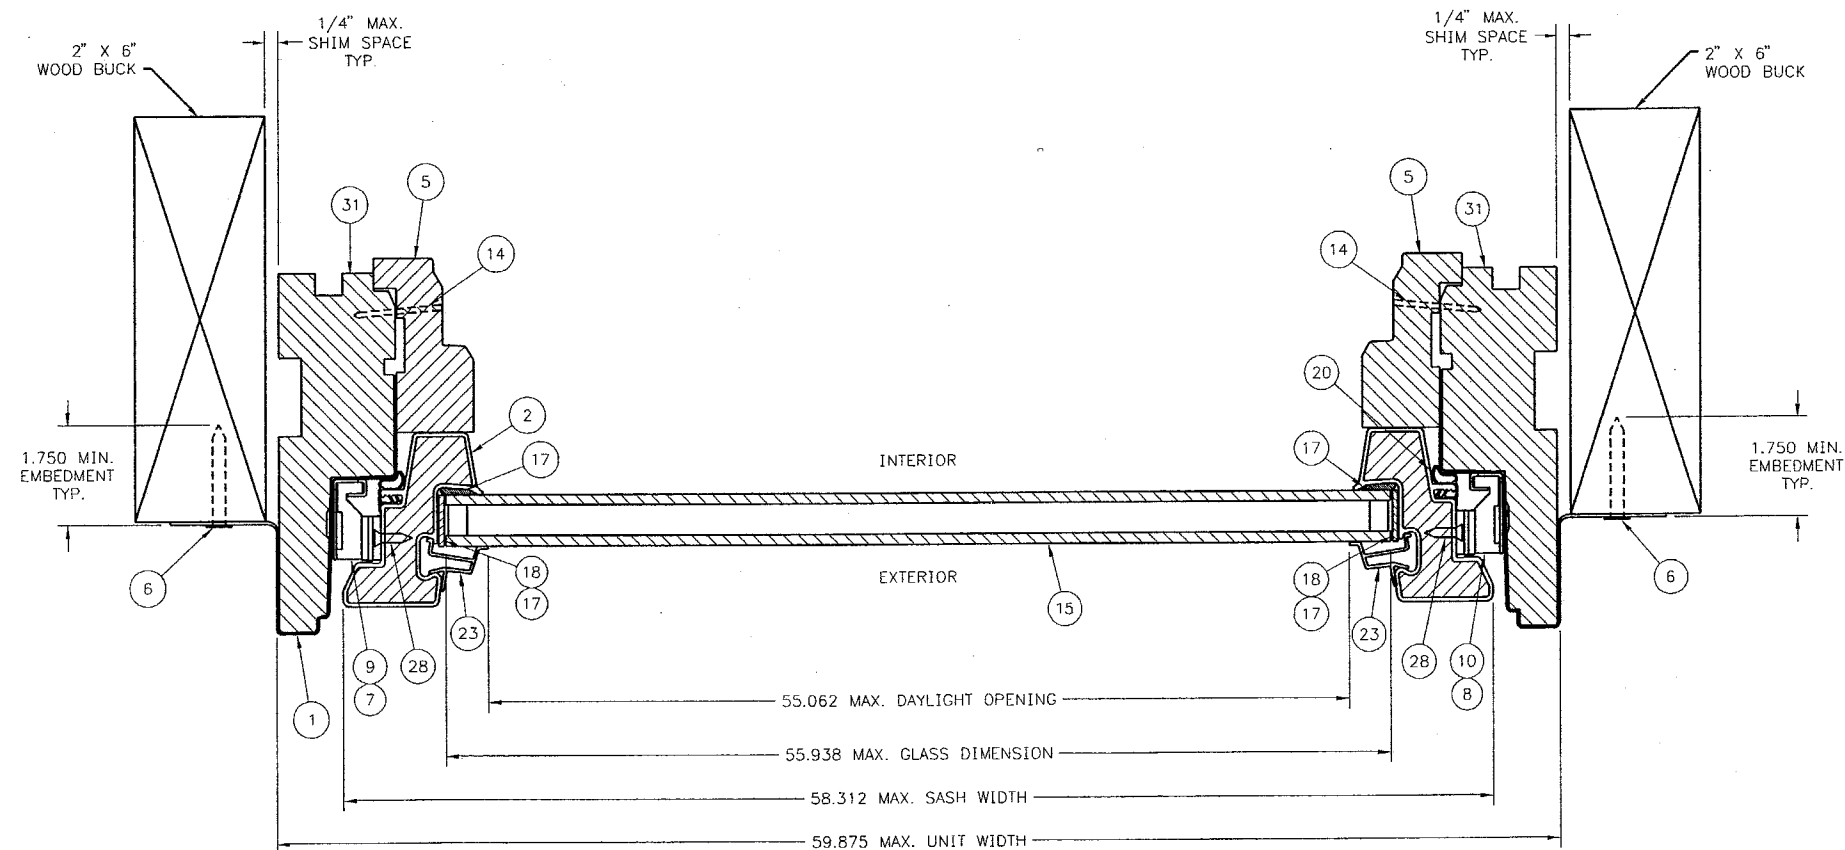


SECTION B-B


APPROVED AS COMPLYING WITH THE
 SOUTH FLORIDA BUILDING CODE
 DATE AUGUST 16, 2001
 BY Ishaq I. Chaudh
 PRODUCT CONTROL DIVISION
 BUILDING CODE COMPLIANCE OFFICE
 ACCEPTANCE NO. 00-0801-01

TITLE	
AWNING WINDOWS STANDARD PRODUCT	
Andersen Corporation Bayport, Minnesota 55003	
<small>THESE DRAWINGS ARE PROVIDED AS A SERVICE BY ANDERSEN CORPORATION FOR THE BENEFIT OF ITS CUSTOMERS. FINAL RESPONSIBILITY FOR ACCURACY OF DESIGN, FINAL SPECIFICATIONS, DRAWINGS AND FOR THE ACTUAL INSTALLATION SUGGESTED BY THESE DRAWINGS LIES WITH THE ARCHITECT, ENGINEER AND/OR CONTRACTOR.</small>	
COPYRIGHT ANDERSEN CORPORATION 1998. ALL RIGHTS RESERVED.	
APPROVE/DATE	DRAWING NUMBER
7/11/01	DADE-40135
SHT. 4 OF 6	

C	7/11/01
B	1/7/01
A	7/14/00
REVISION	

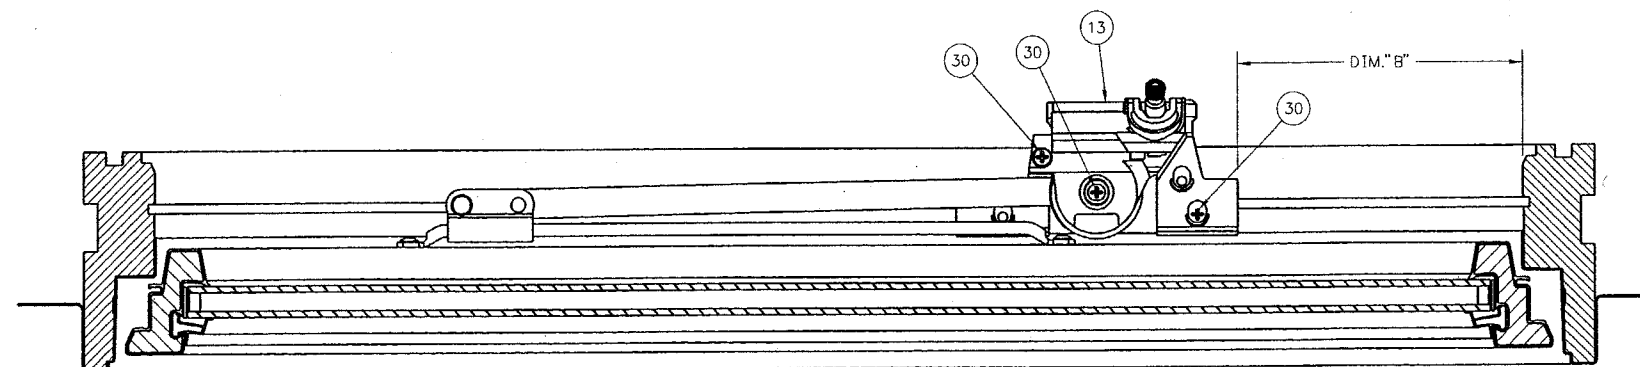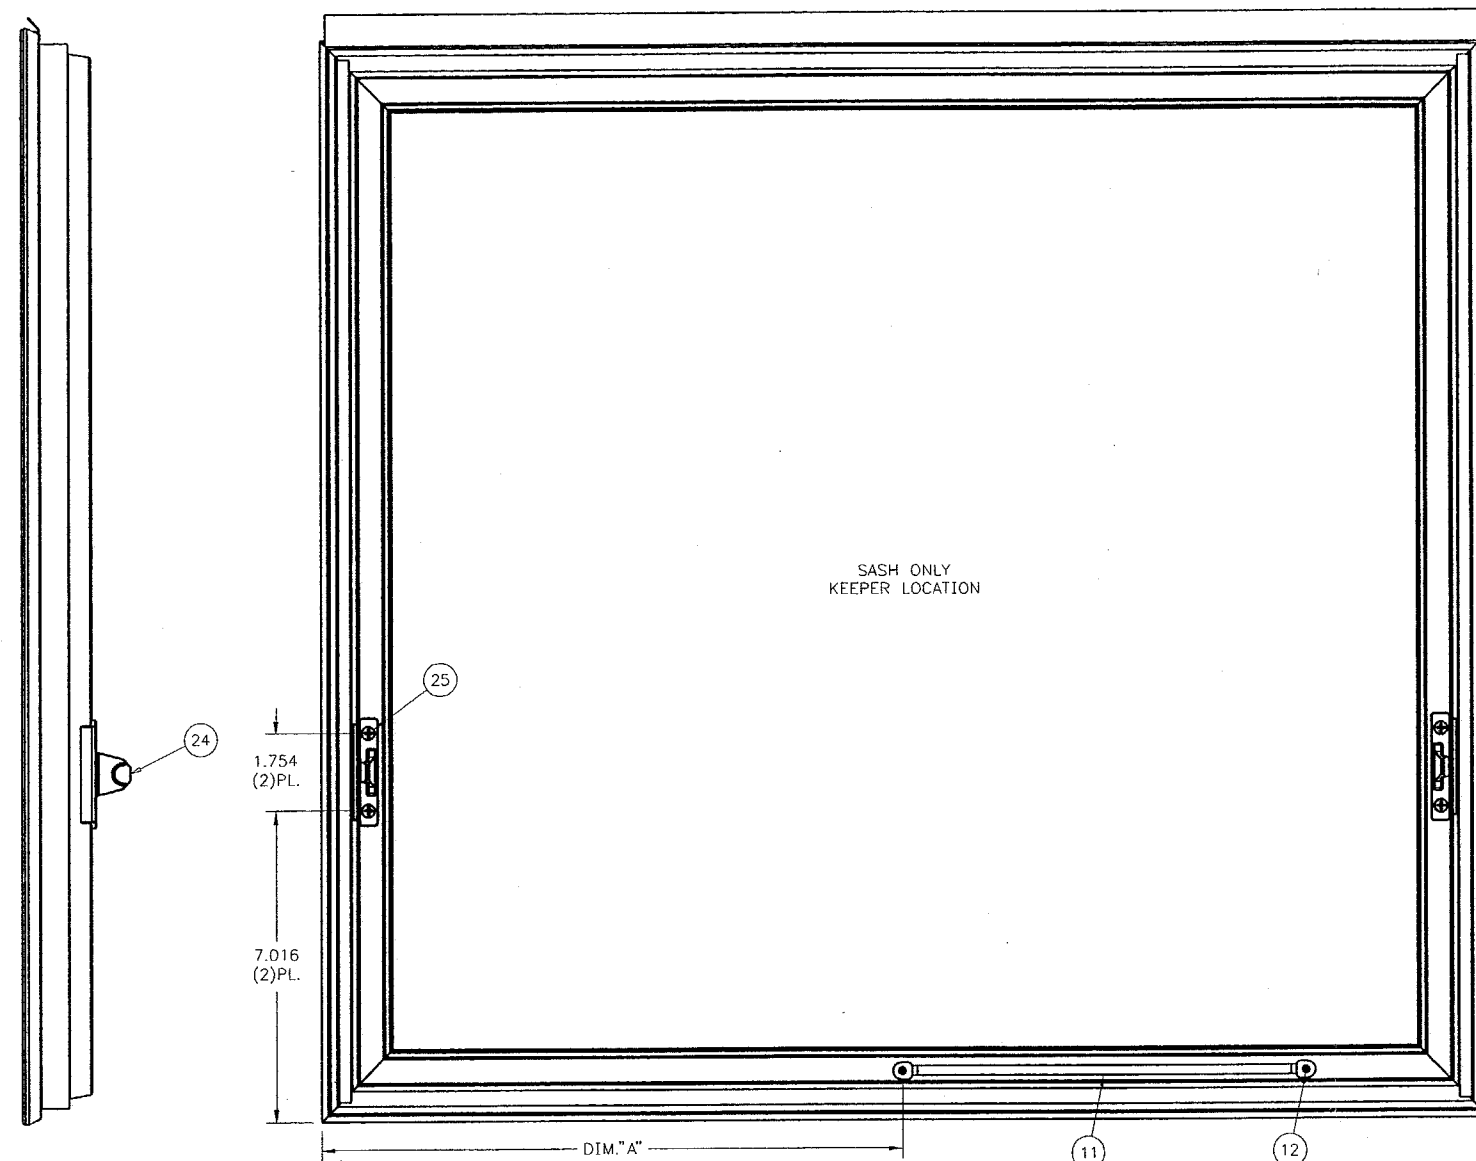

SECTION B-B
STOPS NOT SHOWN

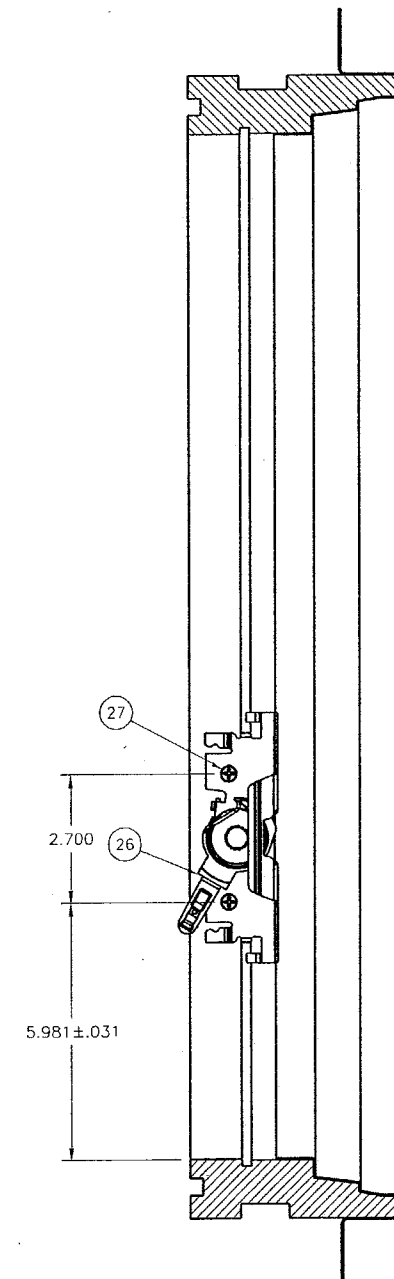


SECTION A-A
SASH & STOPS
NOT SHOWN


APPROVED AS COMPLYING WITH THE
SOUTH FLORIDA BUILDING CODE
DATE: August 16, 2001
BY: Islay I. Chayda
PRODUCT CONTROL DIVISION
BUILDING CODE COMPLIANCE OFFICE
ACCEPTANCE NO. DO-0801-01

TITLE	
AWNING WINDOWS STANDARD PRODUCT	
Andersen Corporation Bayport, Minnesota 55003	
THESE DRAWINGS ARE PROVIDED AS A SERVICE BY ANDERSEN CORPORATION FOR THE BENEFIT OF ITS CUSTOMERS. FINAL RESPONSIBILITY FOR ACCURACY OF DESIGN, FINAL SPECIFICATIONS, DRAWINGS AND FOR THE ACTUAL INSTALLATION SUGGESTED BY THESE DRAWINGS LIES WITH THE ARCHITECT, ENGINEER AND/OR CONTRACTOR.	
COPYRIGHT ANDERSEN CORPORATION 1998. ALL RIGHTS RESERVED.	
APPROVE/DATE	DRAWING NUMBER
7/11/01	DADE-40135
SHT. 5 OF 6	

C	7/11/01
B	1/7/01
A	7/14/00
REVISION	

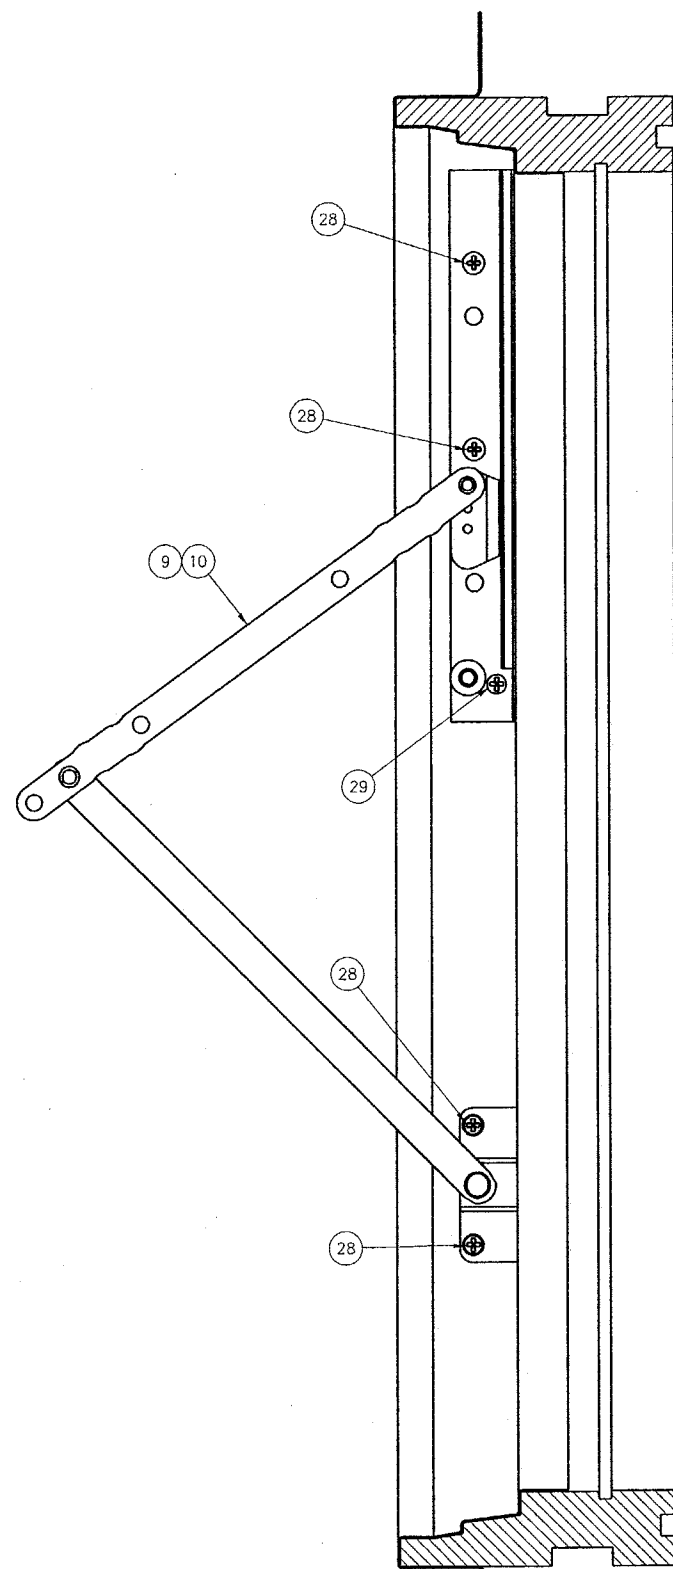

(AN, A, AW)
UNITS ONLY

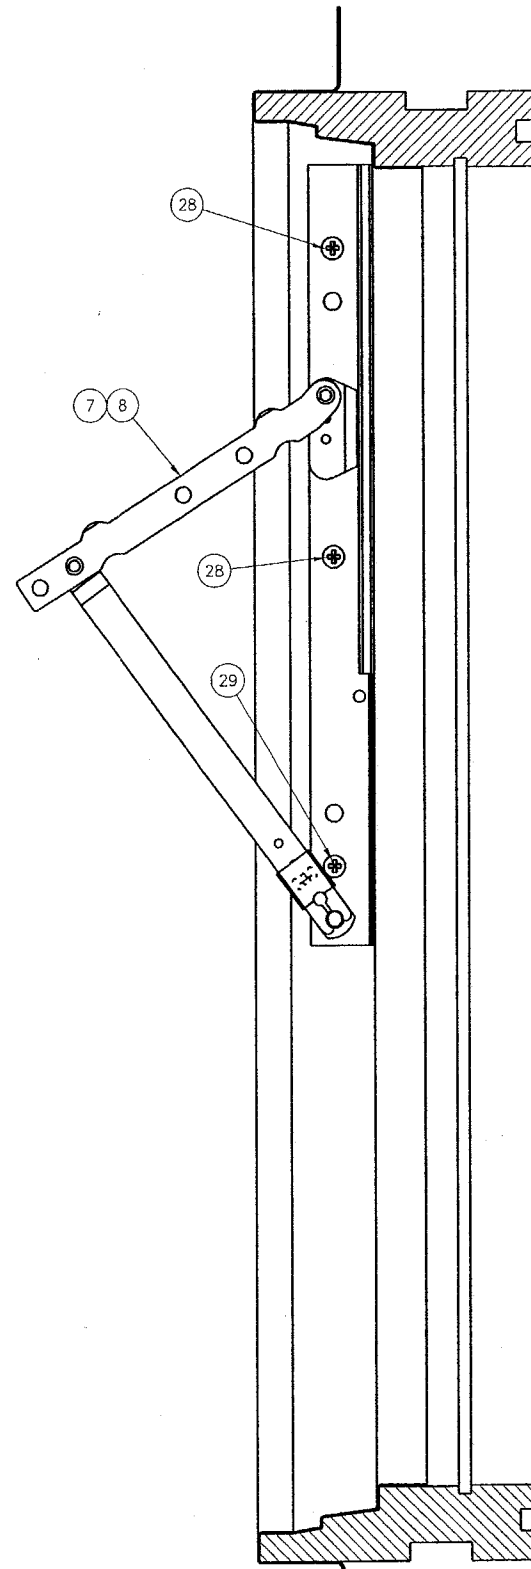

(AR)
UNITS ONLY

APPROVED AS COMPLYING WITH THE
FLORIDA BUILDING CODE
DATE AUGUST 16, 2001
BY Ishag T. Zhande
PROJECT CONTROL DIVISION
BUILDING CODE COMPLIANCE OFFICE
ACCEPTANCE NO. 60-0801.01

TITLE	
AWNING WINDOWS STANDARD PRODUCT	
Andersen Corporation Bayport, Minnesota 55003	
<small>THESE DRAWINGS ARE PROVIDED AS A SERVICE BY ANDERSEN CORPORATION FOR THE BENEFIT OF ITS CUSTOMERS. FINAL RESPONSIBILITY FOR ACCURACY OF DESIGN, FINAL SPECIFICATIONS, DRAWINGS AND FOR THE ACTUAL INSTALLATION SUGGESTED BY THESE DRAWINGS LIES WITH THE ARCHITECT, ENGINEER AND/OR CONTRACTOR.</small>	
COPYRIGHT ANDERSEN CORPORATION 1998. ALL RIGHTS RESERVED.	
APPROVE/DATE	DRAWING NUMBER
7/11/01	DADE-40135
SHT. 6 OF 6	

C	7/11/01
B	1/7/01
A	7/14/00
REVISION	